
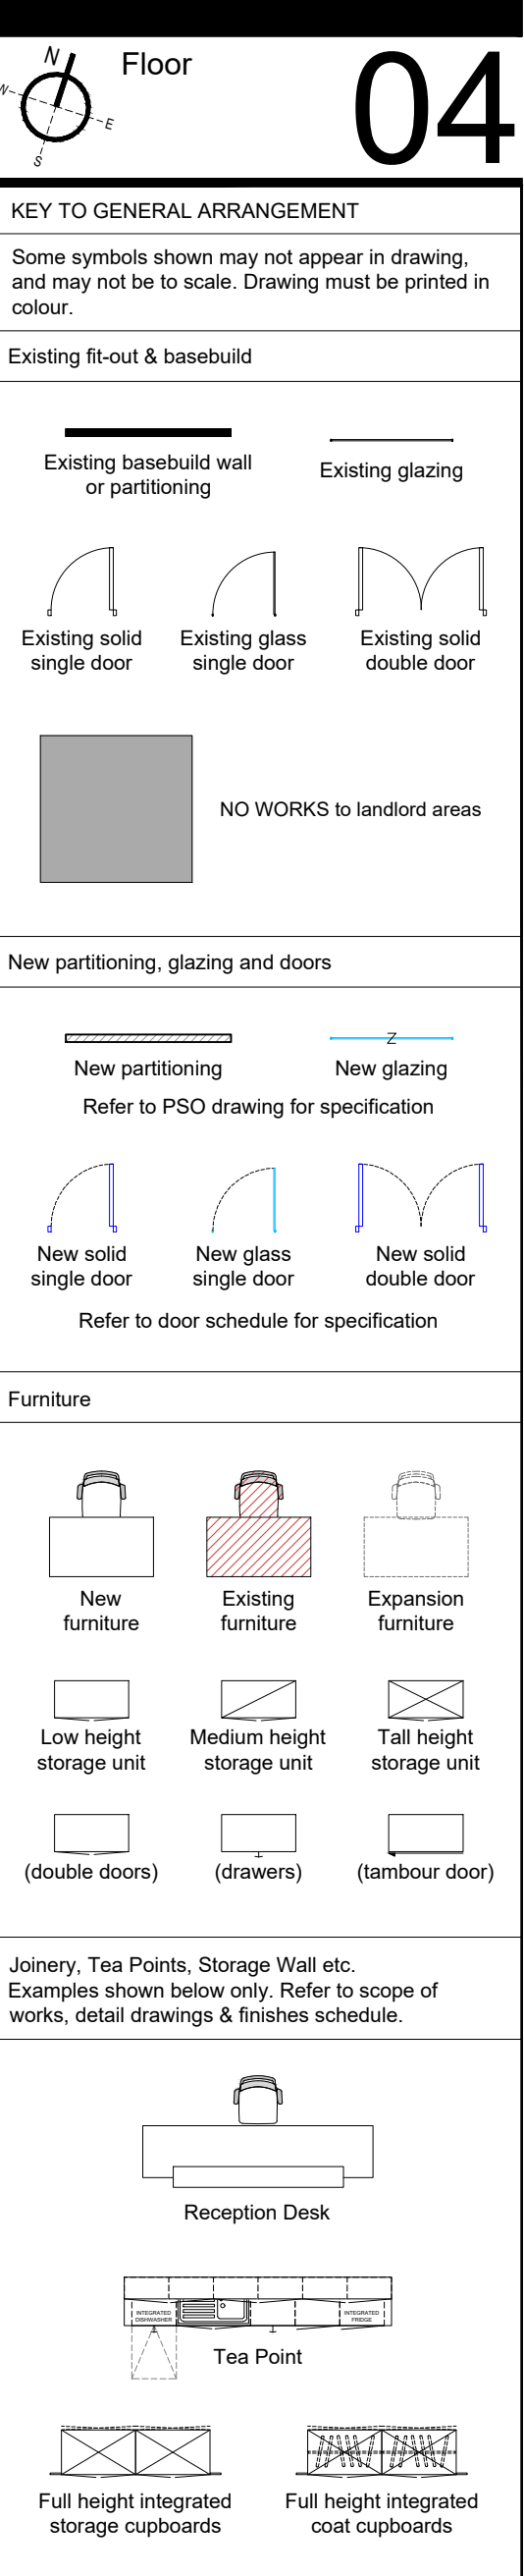


4TH FLOOR NEW FIT OUT

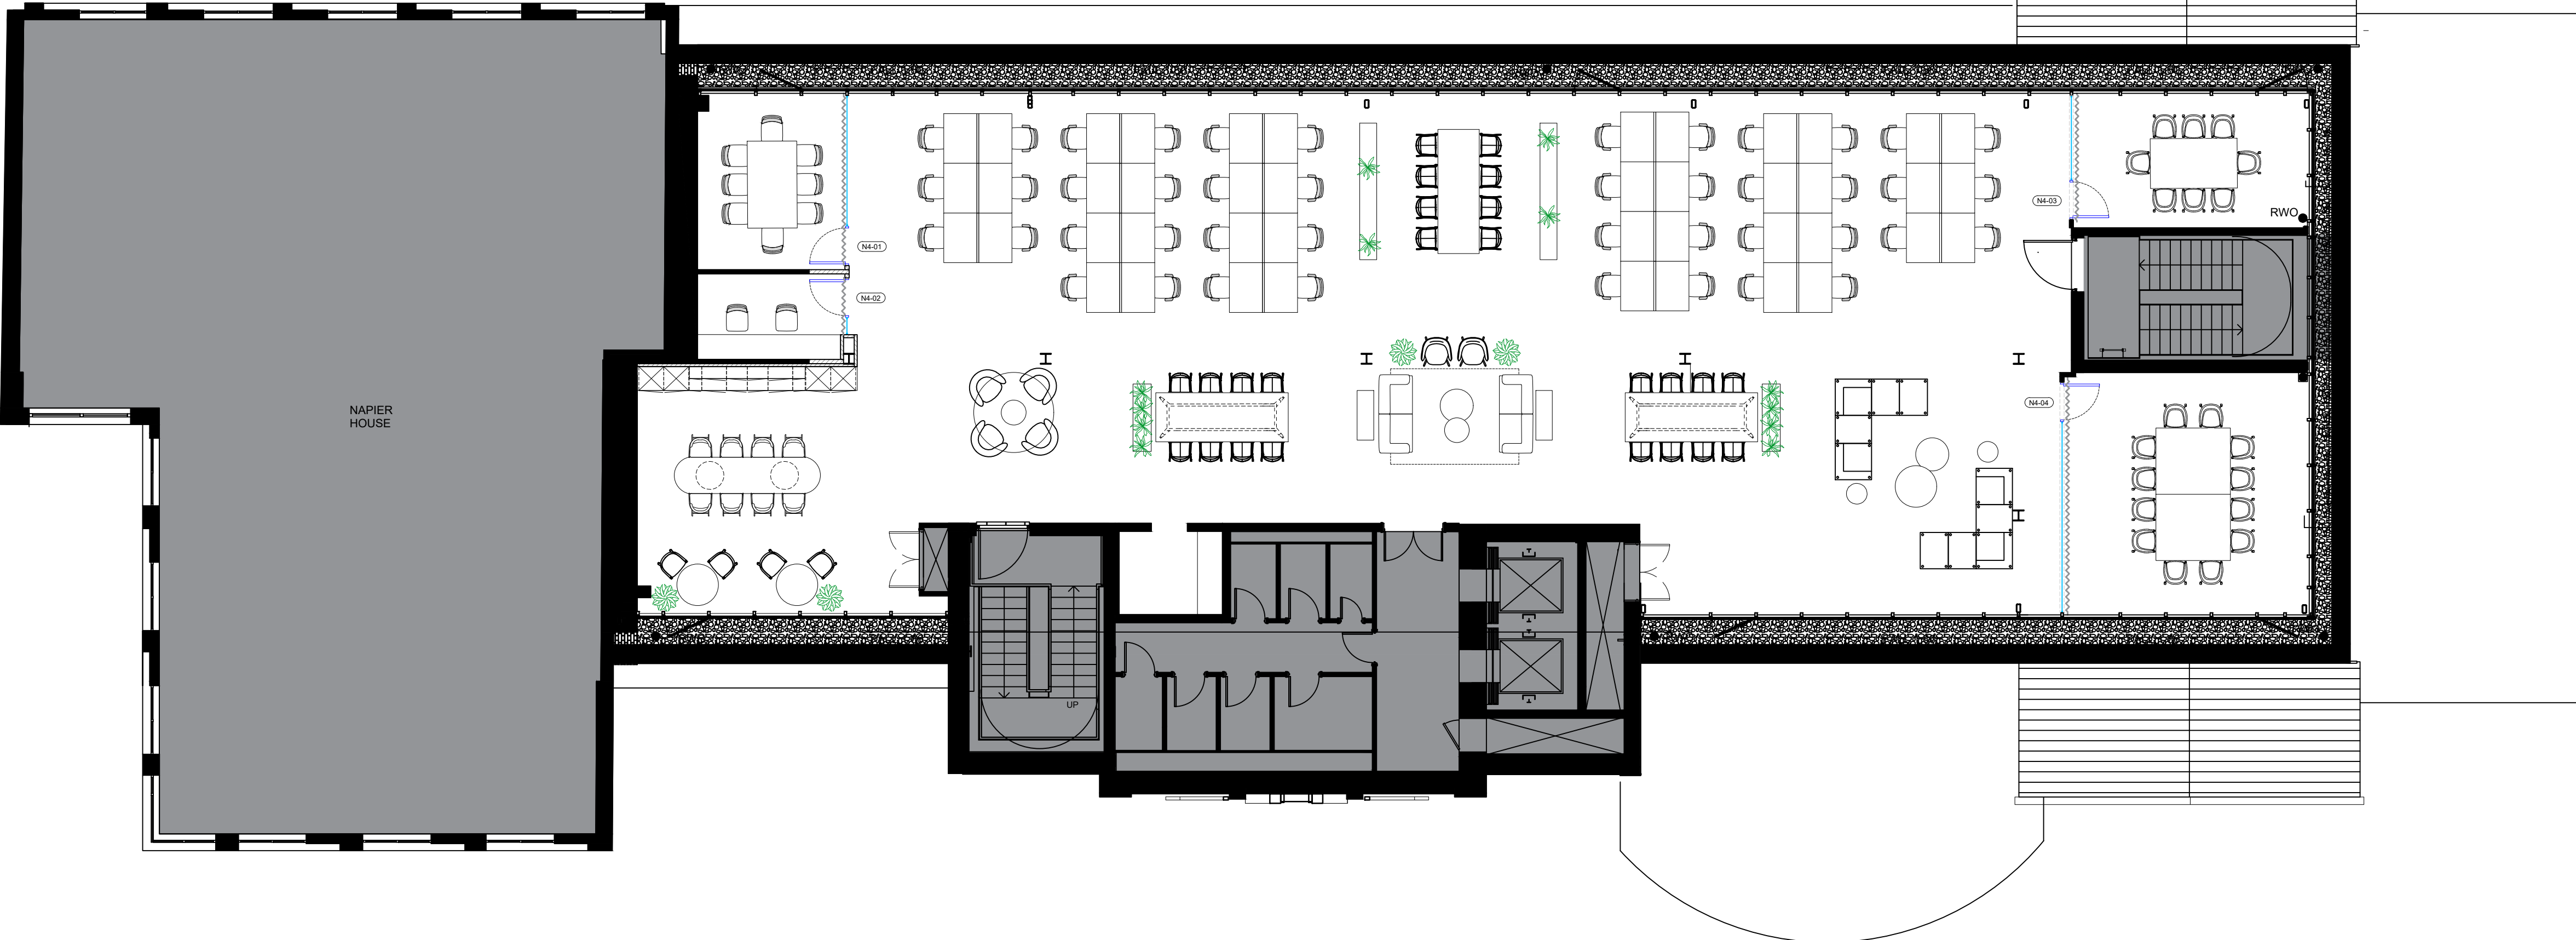

D	As Built	CM/MB	18/10/2024
C	Setting out Added	CM/MB	01/10/2024
B	Bar updated	CM/MB	23/09/2024
A	Curtains added to GA drawing	CM/MB	06/09/2024
-	Drawing first produced	CM/MB	27/07/2024

REV	DESCRIPTION	BY	DATE
-----	-------------	----	------

DRAWING STATUS
AS BUILT

RTP RE CHAPTER
HOUSE LIMITED

Address
Chapter House
16 Brunswick Place
N1 6DZ

Project Number WP272	Floor 04	Detail GA	
Drawing Title Fourth Floor General Arrangement			
Produced by CM/MB	Scale 1:100@A1	Date Created 06/08/2024	Rev D

WHITEPAPER
7-10 Bateman's Row
London, EC2A 3HH
hello@whitepaperco.com
+44 203 859 4444

© COPYRIGHT
This drawing is protected under copyright and at no time should this drawing be reproduced in whole or in part without the permission of White Paper.

NOTE
This drawing is not to be scaled.
Appointed contractors are requested to notify White Paper of any discrepancies or variations relating to setting-out prior to manufacture and construction.
All information is subject to statutory approval and site survey. The general contractor is to carry out a check site survey to confirm that the design intent can be met and that it is appropriate for the environment in which it is to be installed. The general contractor is to notify White Paper in writing of all preparation works that are required to be carried out prior of their works.

whitepaper